

19-23 COMMERCE STREET STOREFRONTS

GENERAL NOTES

- Drawings shall not be scaled for dimensional information.
- The contractor and all subcontractors shall verify all conditions and dimensions in the field and notify the architect of any discrepancies before proceeding with any work. No changes shall be made to any plan without prior comment of the architect.
- All dimensions are from finish face to finish face unless otherwise noted or shown.
- Contractor shall maintain a complete and current set of drawings, construction sketches, and sub-contractor shop drawings at the job site at all times.
- Where the alterations occur, or new and old work join, the immediate surfaces, ceilings, walls, and all finish trim shall be cut, removed, patched, repaired, or refurbished and left in as good a condition as existed prior to the commencement of work.
- Minor details not usually shown or specified yet necessary for proper construction of any part of the work shall be included in the work and the agreed cost of the work as if they were indicated in the drawings.
- All work shall be done in a first-class workmanlike manner by mechanics skilled in their respective trades.
- The contractor shall comply with all rules and regulations of the building owner and all city, state, and federal regulatory agencies having jurisdiction over the work.
- The contractor shall contact the building management to be advised of the rules of the building with respect to construction, when and how deliveries with respect to construction, when and how deliveries and/or removals can be made on regular or over-time, and, in general, any building requirements which will affect their work.
- The contractor shall submit to the designer all fabrication shop drawings and fixture cuts for review.
- The contractor shall furnish a system of temporary lights and water throughout the space under construction, if required.
- The contractor shall remove from the building all rubbish and waste materials for its or subcontractors' work.

DEMOLITION NOTES

- The contractor shall comply with the requirements of all-applicable federal, state and local safety and health regulations regarding the demolition of structures including ansi/nfpd 241- building construction and demolition operations.
- Provide interior shoring, bracing, or temporary supports to prevent movement, settlement or collapse of structures to be demolished and of adjacent facilities and construction to remain. Do not cutting of beams, slabs, columns or the like without prior notice and written approval of the architect.
- Remove existing facade elements as indicated on the drawings with dashed lines.
- Protect all existing work to remain. Protect all existing work from damage by impact.
- Prevent damage to structural elements.
- At juncture of work to remain and work demolished, make neat, straight, plumb, even cuts.
- Any damage incurred outside scope or work must be repaired.
- Remove all interior finish surfaces and all trim, etc.
- Keep passage ways and exterior spaces continuously clean.
- The contractor at all times shall keep the premises free from accumulation of waste materials or rubbish caused by his operations. At the completion of the work, he shall remove all his waste materials from and about the project as well as all his tools, construction equipment, machinery and surplus materials. Utilities must be available at all time - notify managing agency of any planned stoppage in ample time.
- At completion of demolition leave all spaces and surfaces broom clean and free of all demolished materials.
- If the contractor fails to clean up at the completion of the work, the owner may do so and the cost thereof shall be charged to the contractor.
- Salvaged materials: the contractor is responsible to salvage and store off site for reuse all materials so designated on this plan. See list of "Items to be removed and stored off site" for each floor. All materials or fixtures demolished and not salvaged shall become property of the contractor and removed from the site immediately.
- Contractor to coordinate and schedule removal and replacement of windows with window fabricator and architect.

TENANTS SAFETY NOTES

- All work shall be performed in accordance with the Building Code of the City of New York and all other applicable codes and regulations.
- Construction shall be confined to the areas indicated on the approved documents and shall be performed in such a manner so as to create minimum disturbance to the current occupants.
- Dust Control: Work will be confined to the areas of approved construction. All reasonable measures will be taken to minimize the creation of dirt, dust, and other airborne particles, and to confine such matter to the areas of construction. The immediate construction area shall be periodically cleaned to avoid excess accumulation of dust and dirt.
- Construction operation will not involve extended interruption of heating, water, or electrical services to the tenants.
- Construction work will not block any required means of egress.
- Construction work will be conducted only during the hours of 8 a.m. to 5 p.m. Monday through Friday, except legal holidays.
- All building material stored at the site shall be stored in locked areas. Access to these areas shall be controlled by the Owner, or the General Contractor. All building material shall be stored in a neat, orderly manner.
- Fire Safety: building material, including combustible and flammable material, shall be stored in compliance with all applicable codes and regulations, and in accordance with manufacturer's suggestion. All such materials shall be stored in manufacturer's containers or other approved containers, as applicable.
- Electrical Safety: All electrical power shall be shut-off where there is exposed conduit; all electrical power in the construction shall be shut-off except during working hours; electrical power to the stairwell and boiler shall remain on for safety purposes.

FIRE STOPS


- Concealed spaces within partitions, walls, floors, roofs, stairs, furring, pipe spaces, column enclosures, etc. that would permit passage of flame, smoke, fumes, or hot gases from one floor to another floor or roof space, or from one concealed area to another, shall be firestopped to form an effective draft barrier, or shall be filled with noncombustible material in accordance with the requirements of this section. Firestopping shall not be required where a concealed space is sprinklered in accordance with the construction provisions of subchapter seventeen of this chapter, or is constructed as a shaft. [BC 27-345]
- Firestopping materials: In buildings of construction group I, firestopping or fill shall be of noncombustible material that can be shaped, fitted, and fastened permanently secured in position. In buildings of construction group II, firestopping may be of combustible material consisting of wood not less than two inches nominal thickness with tight joints, two layers of one inch nominal thickness assembled so that there are no through joints or of one half inch exterior type plywood with joints backed, except that noncombustible firestopping shall be used in concealed spaces of fire divisions and where in contact with fireplaces, flues, and chimneys. Noncombustible firestopping may be masonry set in mortar, concrete, three-quarter inch thick mortar or plaster on noncombustible lath, plasterboard at least three-eighths of an inch thick, fire-rated wallboard at least five eighths of an inch thick, sheet metal at least No. 14 U.S. std. gage thick, solid web metal structural members, asbestos-cement board at least one-quarter of an inch thick, or equivalent rigid noncombustible material. Mineral, slag, or rockwool may be used for firestopping when compacted to a density of at least three and one half pounds per cubic foot into a confined space of least dimension not more than one-third its second dimension. [BC 27-345(a)]
- The performance of through-penetration fire stops shall be measured and specified according to reference standard RS 5-19. [BC 27-345(a)(1)]
- The commissioner may accept reference standard RS 5-19 test data results from an independent laboratory acceptable to the commissioner pursuant to subdivision (c) of section 27-131, when such data is submitted by a registered architect or licensed professional engineer to justify the usage of fire stops or the details of their installation not specified herein. [BC 27-345(a)(2)]
- Hollow partitions and furred spaces: All hollow partitions and furred out spaces shall be firestopped at each floor level. Firestops shall be the full thickness of the hollow space or furred out space. [BC 27-345(b)]
- Stairs: Concealed spaces within stair construction shall be firestopped between stringers at the top and bottom of each flight of stairs so as not to communicate with concealed spaces in the floor, roof or intermediate landing construction. [BC 27-345(c)]
- Ceiling spaces: Floor or roof assemblies required to have a fire-resistance [sic] rating shall have any concealed spaces therein firestopped in accordance with section 27-327 of this subchapter. [BC 27-345(d)]
- Exterior cornices: Exterior cornices and eaves, constructed of combustible materials or with combustible framing, shall be firestopped at the ends of fire divisions and party walls, and at maximum intervals of twenty feet. If not continuous, they shall have closed ends and at least four inches separation between adjoining sections. [BC 27-345(e)]
- Trim and finish: Where combustible trim and finish is permitted all hollow spaces shall be firestopped at ten foot intervals or shall be solidly filled with noncombustible materials. [BC 27-345(f)]
- Duct and pipe spaces: Ducts and pipes enclosed in construction that does not meet the requirements of this code for shaft construction shall be firestopped at every floor level. [BC 27-345(g)]
- Inspection of firestopping: The installation of all required firestopping shall be subject to the controlled inspection requirements of section 27-132 of article seven of subchapter one of this chapter, except that the architect or engineer need not be retained by the owner. Firestopping shall not be concealed from view until inspected. [BC 27-345(h)]

CONSTRUCTION CLASS NOTE

- C26-241.0 Class 3--Non-Fireproof structures.
- a. Class 3 non-fireproof structures are those which are made of incombustible materials or assemblies of materials inadequate to meet the fire resistive rating requirements of class 1 or class 2 structures, or in which the exterior walls are of masonry or reinforced concrete and the interior framing is partly or wholly of wood or unprotected iron or steel. The exterior walls of such structures shall be made of incombustible materials or assemblies of materials with a fire resistive rating of at least one hour when walls or* non-bearing, two hours when walls are non-bearing and protection of openings is required, and three hours when they are bearing walls; the floor above the cellar or basement and columns below such floors be constructed of incombustible materials or assemblies of materials having a fire resistive rating of three hours (except in residence structures three stories or forty feet in height), shafts and required stairway enclosures may be made of incombustible materials or assemblies having a fire resistive rating of at least one hour). The exterior walls if of masonry shall be as provided in sections C26-412.0 through C26-467.0
- b. This section shall not be construed as applying to private dwellings of forty feet and four stories or less in height (except as to exterior walls). (As amended by local Law 33 of 1948 in effect may 25, 1948.)
- c. Exterior walls of private dwellings of class 3, non-fireproof construction may be constructed of incombustible material having a fire resistive rating of at least one hour, provided the building does not exceed one story in height and that the building is separated by at least four feet from any lot line and from any other building. (Subd. c as added by Local Law 183 of 1953 in effect December 26, 1953.)
- d. Exterior walls of central station power generating plants where located at least 30 feet distant from common lot line may be of incombustible materials without specified fire resistive rating and may have interior steel without fireproofing. (Paragraph added to subd. c. by Local Law 59 of 1960 in effect September 21, 1960.)

ZONING CALCULATIONS

- No change to building height, bulk, size, or floor area.
- No change to use, occupancy, or egress.

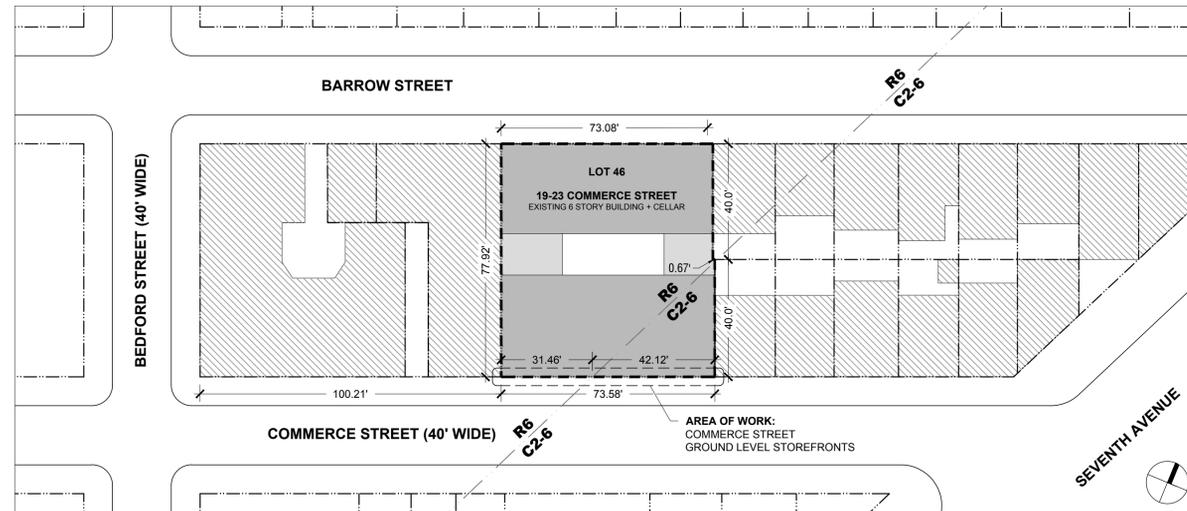

1 LOT DIAGRAM SCALE: 1:350

GENERAL DATA

Floors	1st Floor
Block	587
Lot	46
Zoning District	R6, C2-6
Zoning Map	12A
Community Board	102
Construction Class	Old Code Class 3 Non-Fireproof
Occupancy	Old Code Residential

LIST OF DRAWINGS

L1	LOT DIAGRAM, NOTES, BUILDING INFO, AND LIST OF DRAWINGS
L2	PROPOSED FLOOR PLAN
L3	ENLARGED FLOOR PLAN
L4	GROUND FLOOR PARTIAL ELEVATIONS
L5	19 COMMERCE ST STOREFRONT ELEVATIONS
L6	23 COMMERCE ST STOREFRONT ELEVATIONS
L7	SECTIONS AND DETAILS: WESTERMOST STOREFRONT
L8	SECTIONS AND DETAILS: 2ND WESTERMOST STOREFRONT
L9	PHOTOS: HISTORIC AND PRIOR-TO-CONSTRUCTION
L10	PHOTOS: AS-BUILT CONDITIONS
L11	PHOTOS: 19 COMMERCE STREET FACADE DETAILS
L12	PHOTOS: 23 COMMERCE STREET FACADE DETAILS



2 AS-BUILT ELEVATION VIEWS FROM COMMERCE STREET



MKA
MK ARCHITECTURE, PC
217 Broadway, Suite 610
New York, NY 10007
212 352 8866
MKArchitecture.com

№	DATE	ISSUE/REVISION	BY
	09/13/2016	LPC SUBMISSION	JC

PROJECT:
**19-23 COMMERCE STREET
NEW YORK, NY 10014
STOREFRONTS**

TITLE:
**LOT DIAGRAM, NOTES,
BUILDING INFO, AND
LIST OF DRAWINGS**

SEAL & SIGNATURE:	DATE:	03/29/2016
	PROJECT №:	21019
	DRAWING BY:	JC
	CHK BY:	PR
	SCALE:	AS NOTED

DWG №:
L1
01 of 12

© Copyright 2016 by MK Architecture, P.C. All rights reserved.

It is a violation of the law for any person, unless acting under the direction of a licensed architect, to alter an item in any way. If an item bearing the seal of an architect is altered, the altering architect shall affix to his item the seal and the notation "altered by" followed by his signature and the date of such alteration, and a specific description of the alteration.

MKA

MK ARCHITECTURE, PC

217 Broadway, Suite 610
New York, NY 10007
212 352 8866
MKArchitecture.com

Nº	DATE	ISSUE/REVISION	BY
	09/13/2016	LPC SUBMISSION	JC

PROJECT:
19-23 COMMERCE STREET
NEW YORK, NY 10014
STOREFRONTS


TITLE:
PROPOSED FLOOR PLAN

SEAL & SIGNATURE:	DATE:	03/29/2016
	PROJECT Nº:	21019
	DRAWING BY:	JC
	CHK BY:	PR
	SCALE:	AS NOTED

DWG Nº:
L2
02 of 12

© Copyright 2016 by MK Architecture, P.C. All rights reserved.

It is a violation of the law for any person, unless acting under the direction of a licensed architect, to alter an item in any way. If an item bearing the seal of an architect is altered, the altering architect shall affix to his item the seal and the notation "altered by" followed by his signature and the date of such alteration, and a specific description of the alteration.

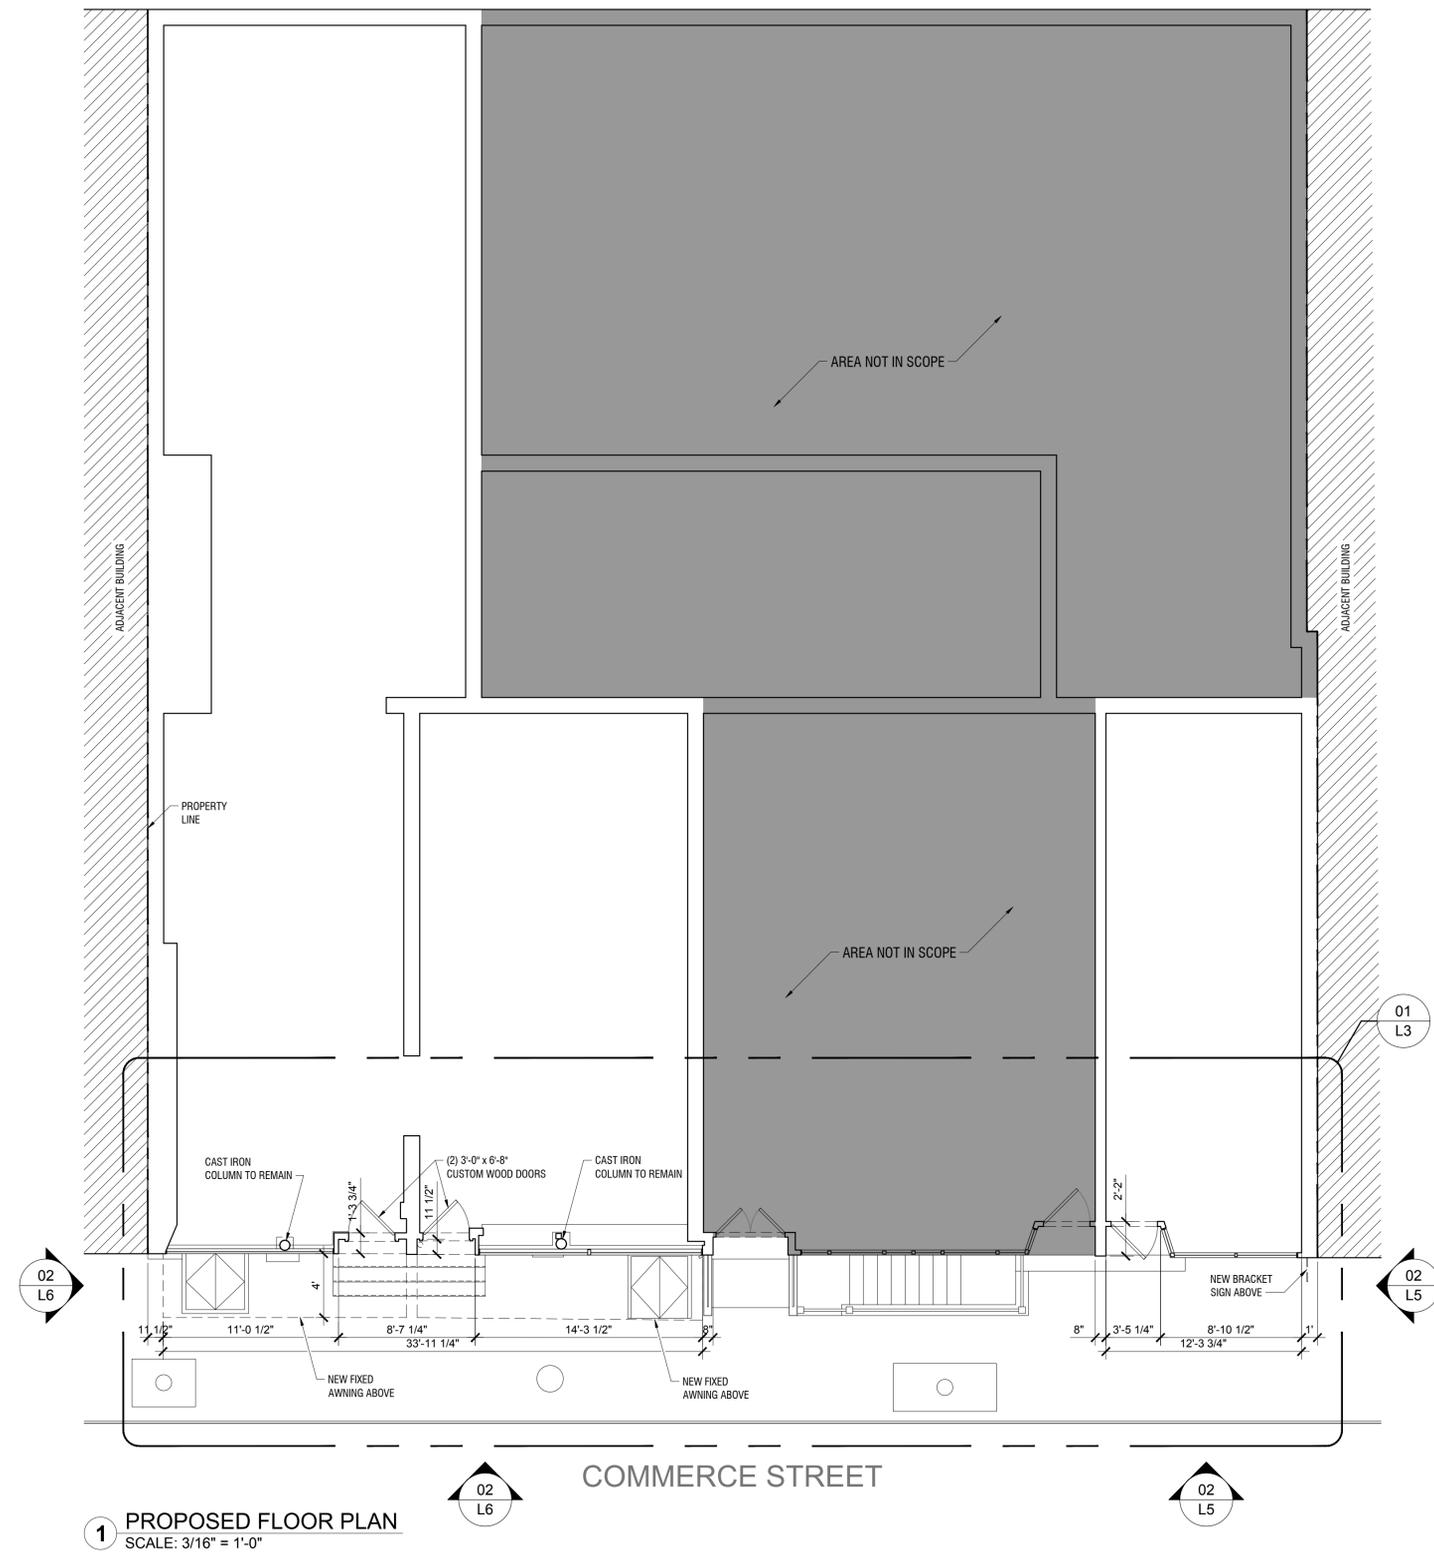

1 PROPOSED FLOOR PLAN
SCALE: 3/16" = 1'-0"

MKA

MK ARCHITECTURE, PC

217 Broadway, Suite 610
New York, NY 10007
212 352 8866
MKArchitecture.com

№	DATE	ISSUE/REVISION	BY
	09/13/2016	LPC SUBMISSION	JC

PROJECT:
19-23 COMMERCE STREET
NEW YORK, NY 10014
STOREFRONTS

TITLE:
**ENLARGED
FLOOR PLAN**

SEAL & SIGNATURE:	DATE:	03/29/2016
	PROJECT №:	21019
	DRAWING BY:	JC
	CHK BY:	PR
	SCALE:	AS NOTED


DWG №:

L3

03 of 12

© Copyright 2016 by MK Architecture, P.C. All rights reserved.

It is a violation of the law for any person, unless acting under the direction of a licensed architect, to alter an item in any way. If an item bearing the seal of an architect is altered, the altering architect shall affix to his item the seal and the notation "altered by" followed by his signature and the date of such alteration, and a specific description of the alteration.

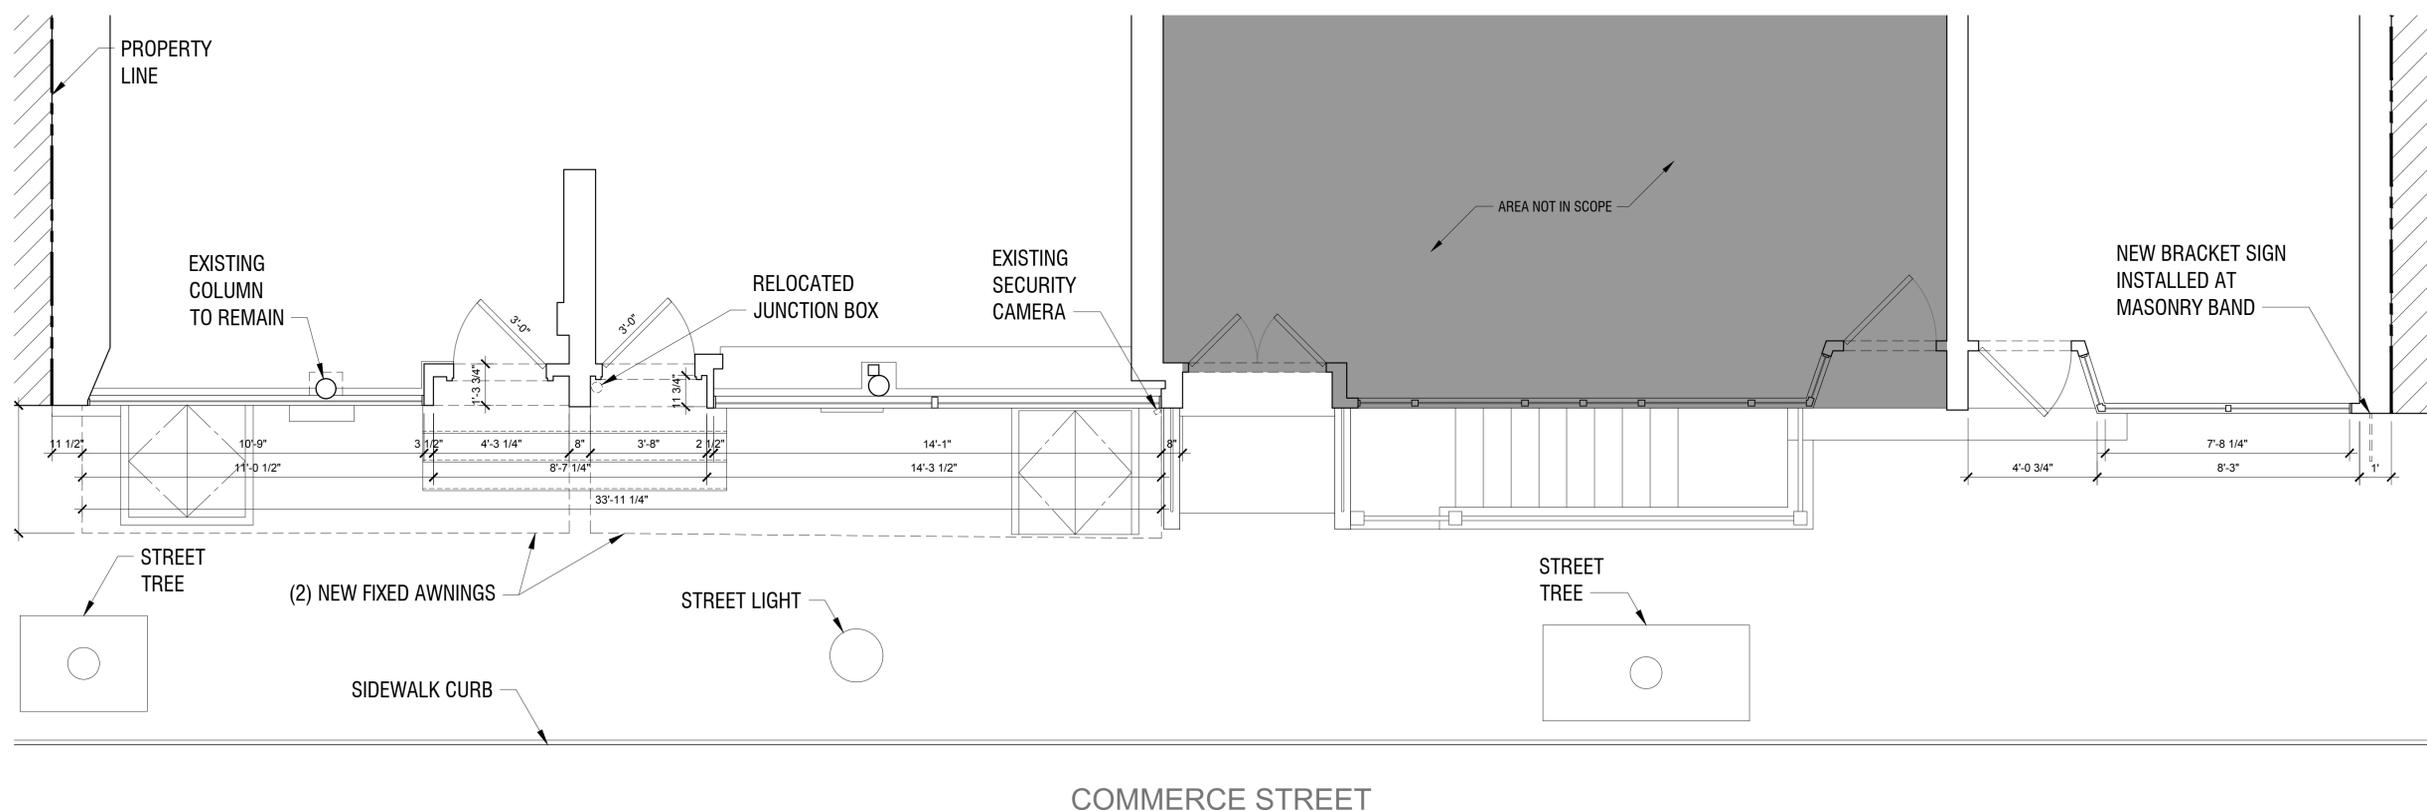

1 ENLARGED FLOOR PLAN
SCALE: 3/8" = 1'-0"




SCOPE OF WORK FILED TO RESOLVE LPC VIOLATIONS

16-0843, 16-0844, 16-0845


MKA

MK ARCHITECTURE, PC

217 Broadway, Suite 610
New York, NY 10007
212 352 8866
MKArchitecture.com

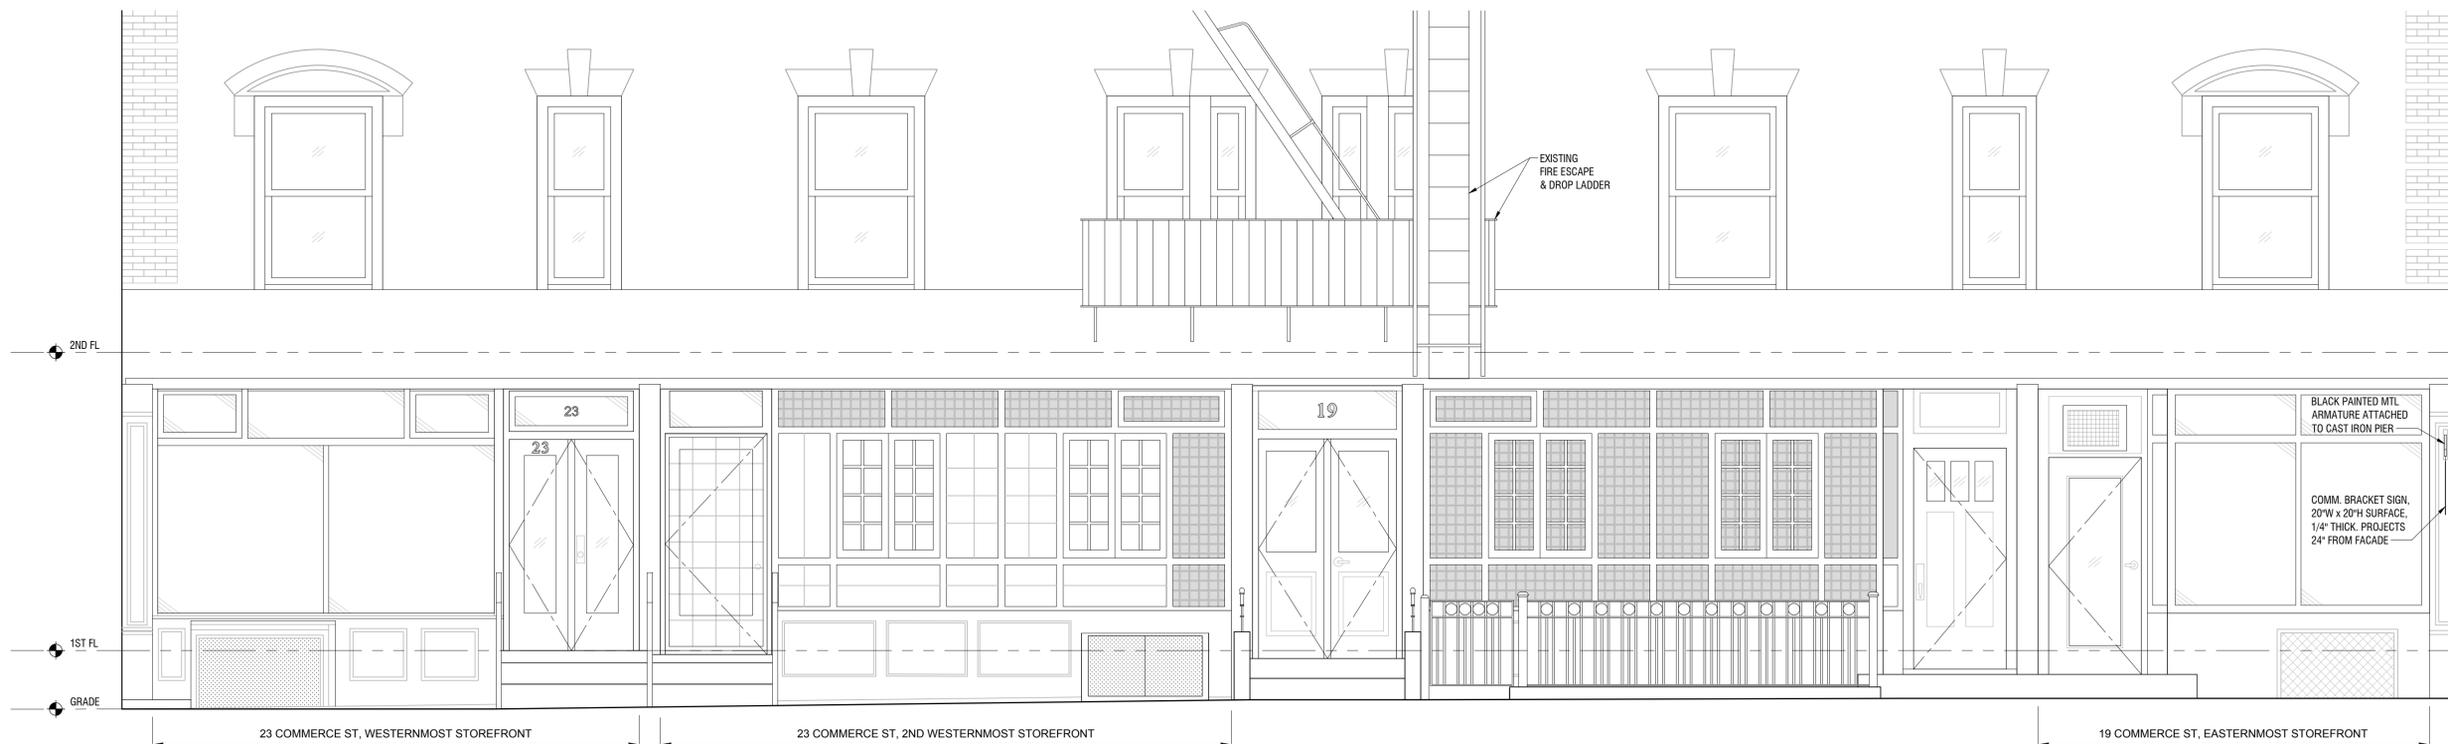

1 COMMERCE STREET PARTIAL ELEVATION: PRIOR-TO-CONSTRUCTION
SCALE: 3/8" = 1'-0"

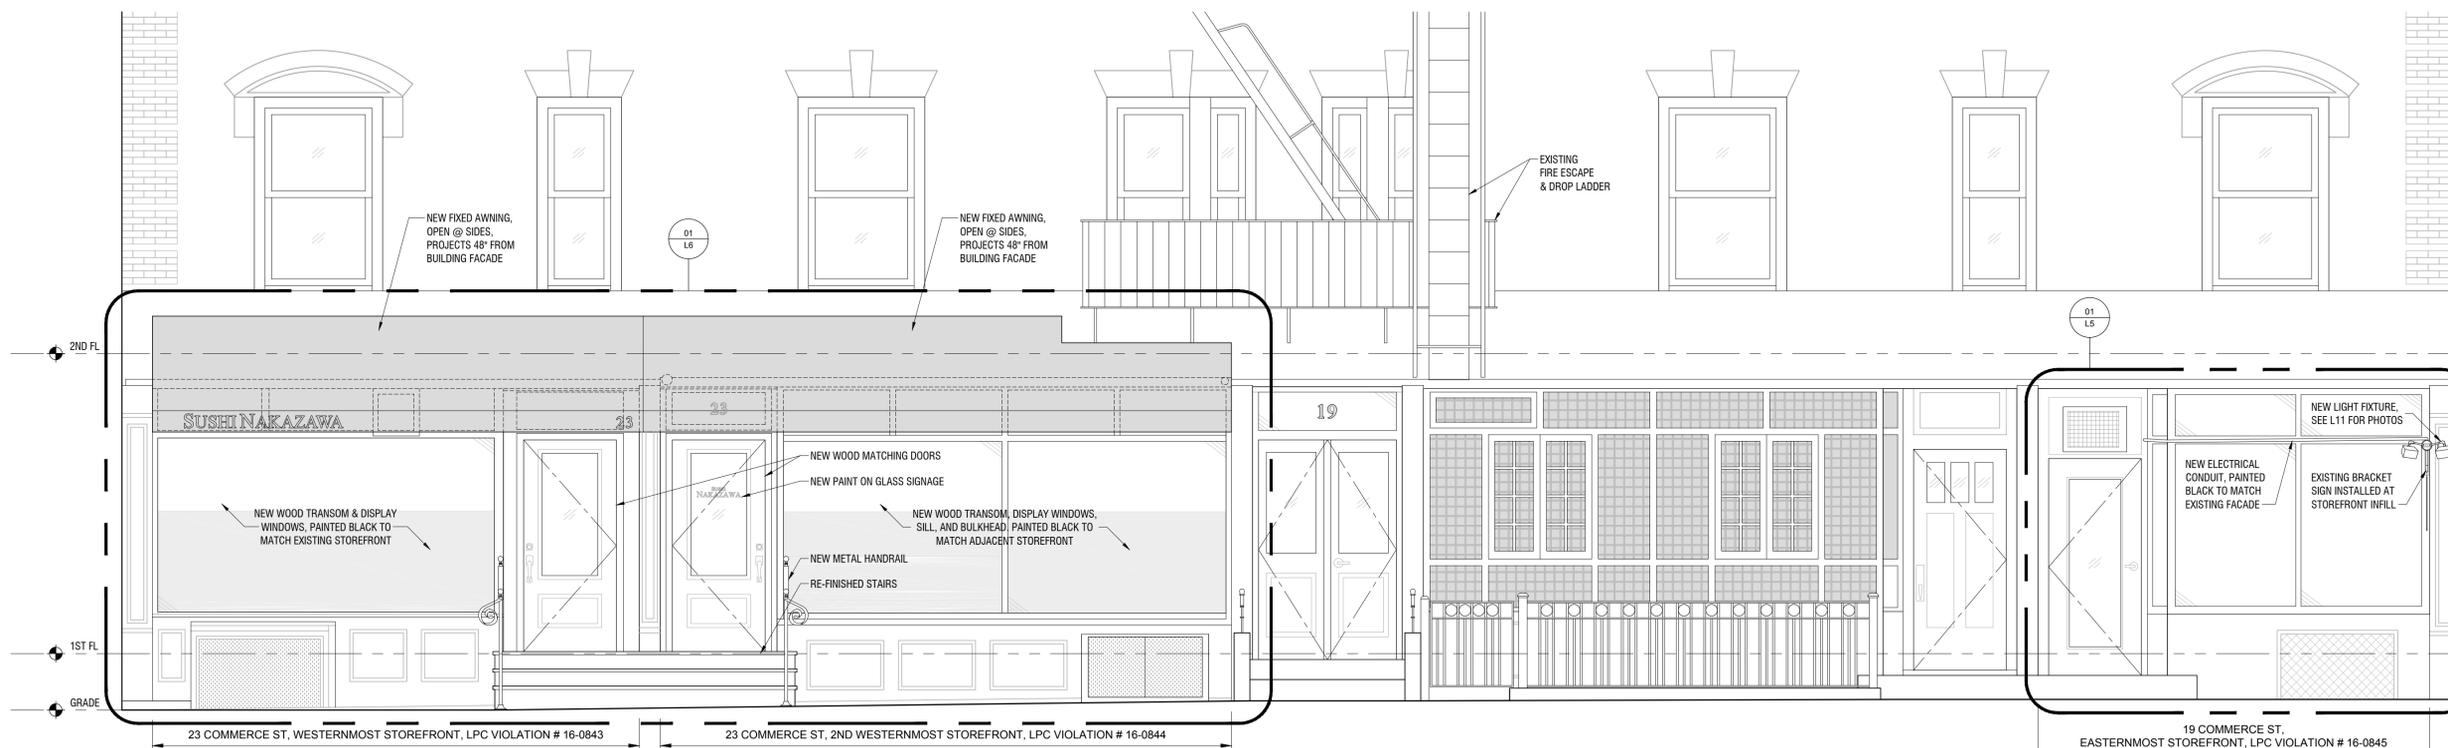

2 COMMERCE STREET PARTIAL ELEVATION: AS-BUILT CONDITION
SCALE: 3/8" = 1'-0"

№	DATE	ISSUE/REVISION	BY
	09/13/2016	LPC SUBMISSION	JC

PROJECT:
19-23 COMMERCE STREET
NEW YORK, NY 10014
STOREFRONTS


TITLE:
GROUND FLOOR
PARTIAL ELEVATIONS

SEAL & SIGNATURE:	DATE:	03/29/2016
	PROJECT №:	21019
	DRAWING BY:	JC
	CHK BY:	PR
	SCALE:	AS NOTED


DWG №:
L4

© Copyright 2016 by MK Architecture, P.C. All rights reserved.


It is a violation of the law for any person, unless acting under the direction of a licensed architect, to alter an item in any way. If an item bearing the seal of an architect is altered, the altering architect shall affix to his item the seal and the notation "altered by" followed by his signature and the date of such alteration, and a specific description of the alteration.

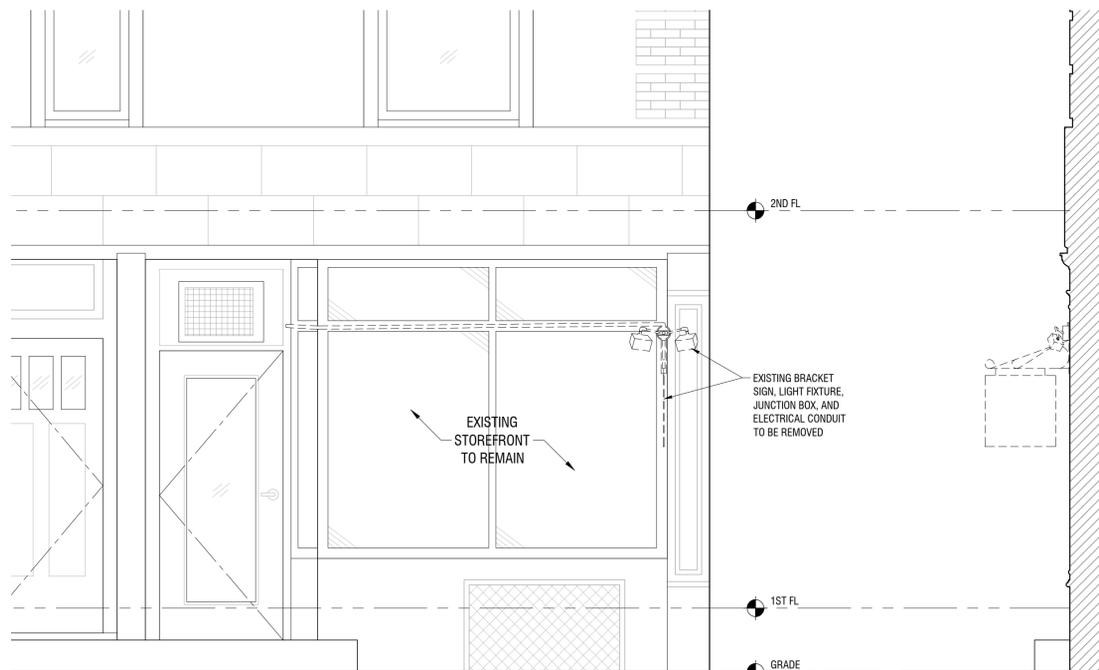

1 EXISTING 19 COMMERCE STREET FRONT & SIDE ELEVATIONS
SCALE: 1/2" = 1'-0"

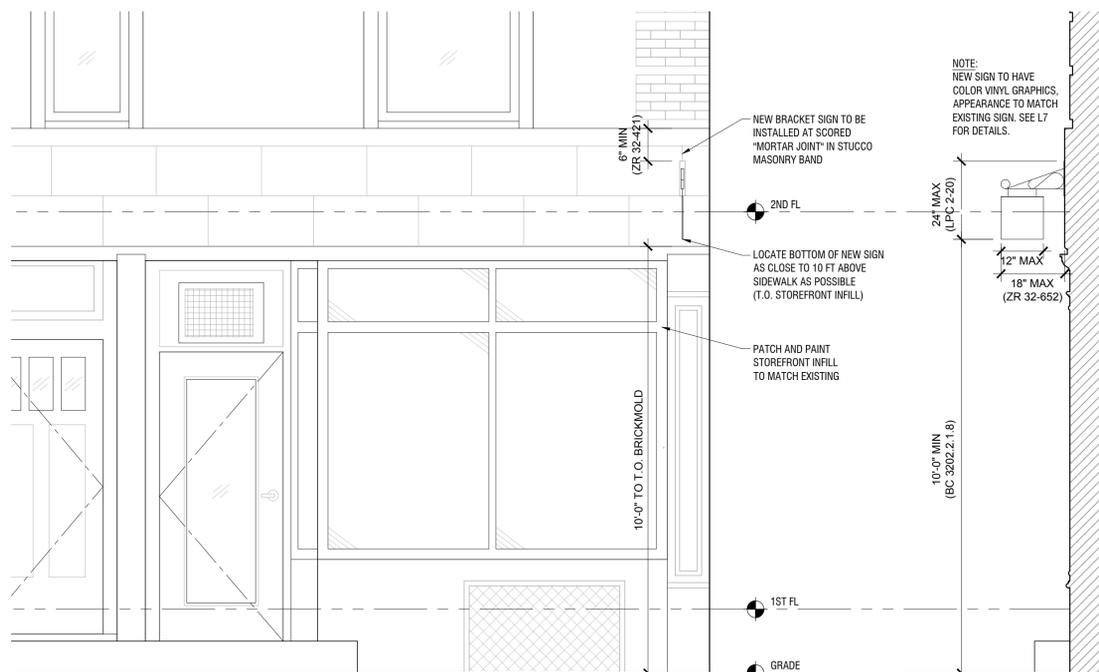

2 PROPOSED 19 COMMERCE STREET FRONT & SIDE ELEVATIONS
SCALE: 1/2" = 1'-0"

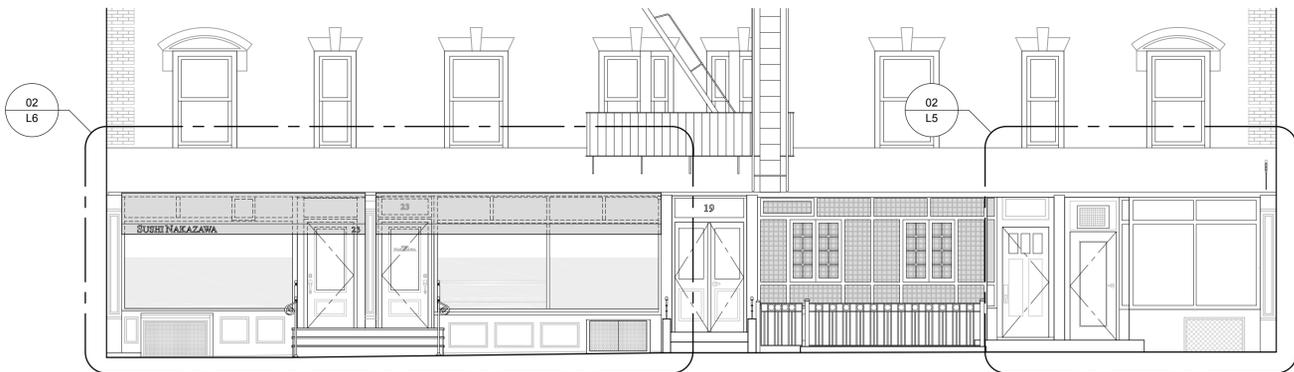

3 PROPOSED COMMERCE STREET PARTIAL ELEVATION
SCALE: 3/16" = 1'-0"


№	DATE	ISSUE/REVISION	BY
	09/13/2016	LPC SUBMISSION	JC

PROJECT:
**19-23 COMMERCE STREET
NEW YORK, NY 10014
STOREFRONTS**


TITLE:
**19 COMMERCE ST
STOREFRONT ELEVATIONS**

SEAL & SIGNATURE:	DATE:
	03/29/2016
	PROJECT №: 21019
	DRAWING BY: JC
	CHK BY: PR
	SCALE: AS NOTED

DWG №:
L5

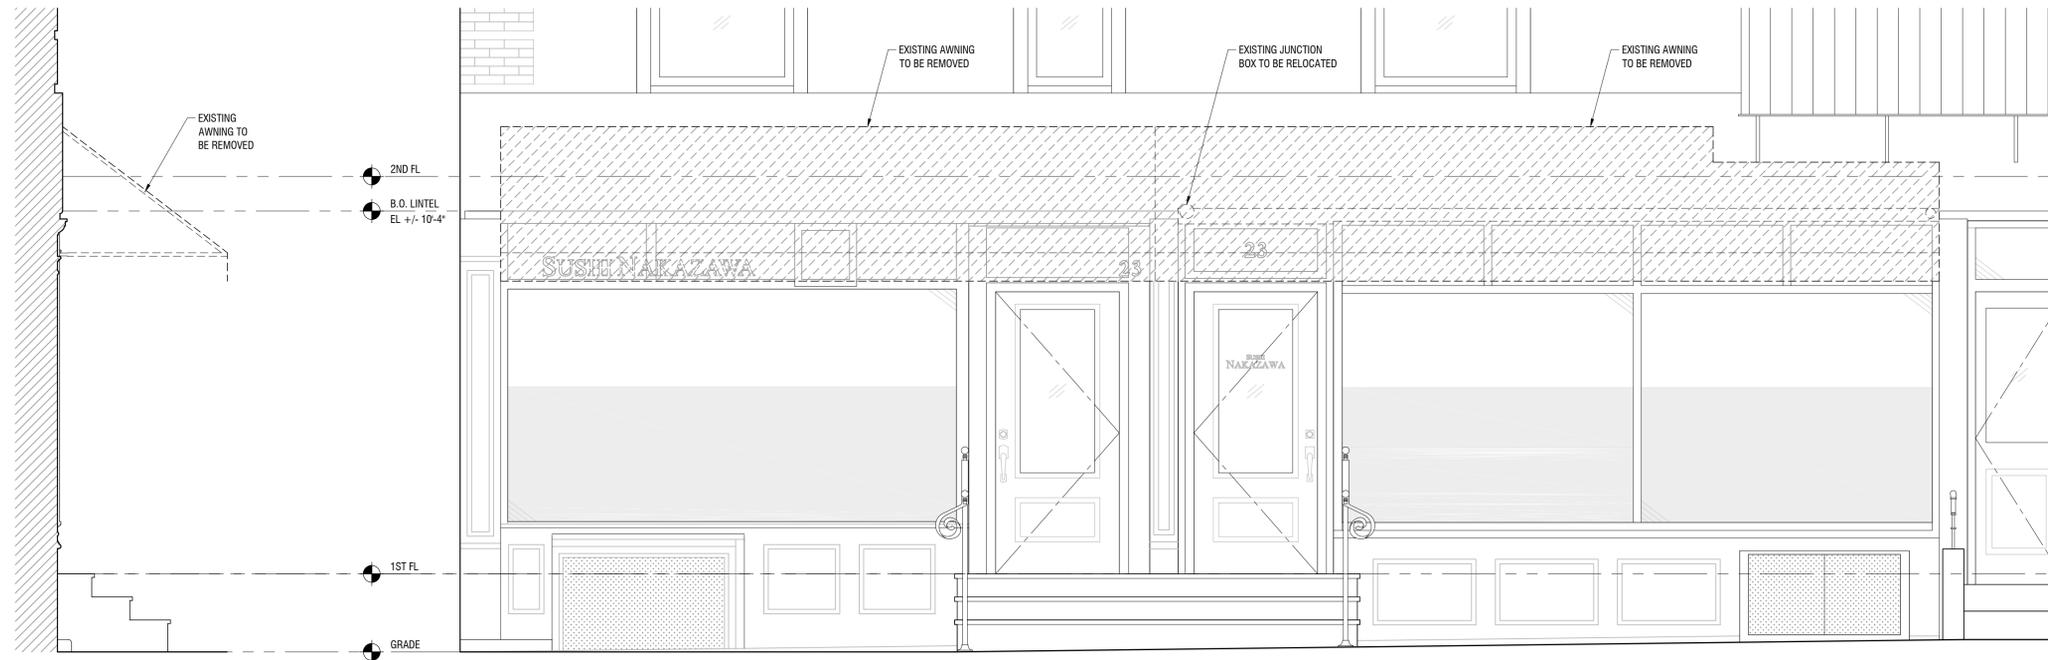

1 EXISTING 23 COMMERCE STREET FRONT & SIDE ELEVATIONS
SCALE: 1/2" = 1'-0"

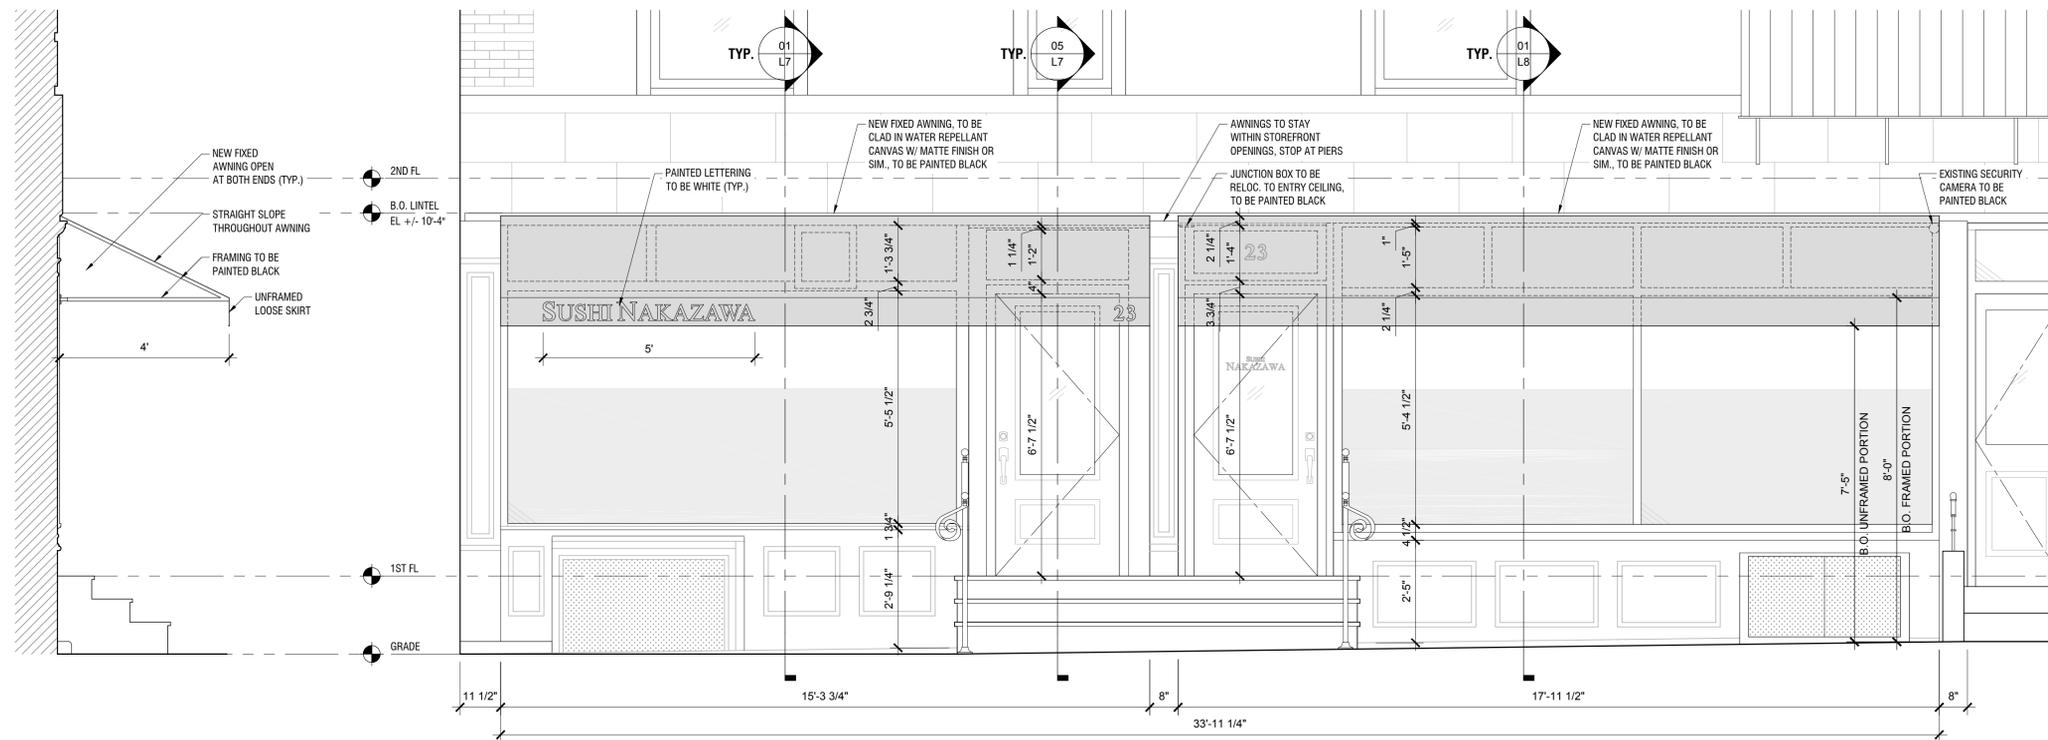

2 PROPOSED 23 COMMERCE STREET FRONT & SIDE ELEVATIONS
SCALE: 1/2" = 1'-0"

NOTES

- 1 PATCH AND REPAIR STUCCO MASONRY BAND TO MATCH ADJACENT SURFACE AS REQUIRED (TYP.)
- 2 NEW (2) FIXED AWNINGS TO ALIGN WITH AND MATCH EACH OTHER IN MATERIAL AND APPEARANCE.
- 2 ALL ELECTRICAL WIRING FOR SECURITY CAMERA AND JUNCTION BOX TO BE INSTALLED THROUGH STOREFRONT INFILL. NO ELECTRICAL CONDUITS TO BE INSTALLED ON BUILDING FACADE.


NO	DATE	ISSUE/REVISION	BY
	09/13/2016	LPC SUBMISSION	JC

PROJECT:
**19-23 COMMERCE STREET
NEW YORK, NY 10014
STOREFRONTS**


TITLE:
**23 COMMERCE ST
STOREFRONT ELEVATIONS**

SEAL & SIGNATURE:	DATE:	03/29/2016
	PROJECT NO:	21019
	DRAWING BY:	JC
	CHK BY:	PR
	SCALE:	AS NOTED


DWG NO:
L6

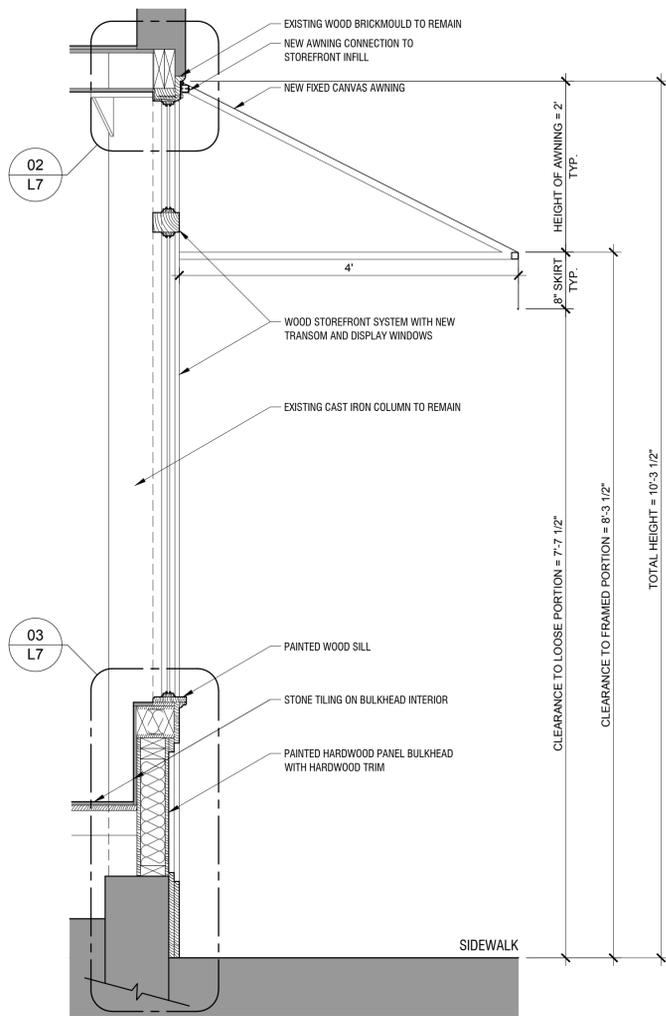


1 SECTION THRU STOREFRONT & AWNING
SCALE: 1" = 1'-0"

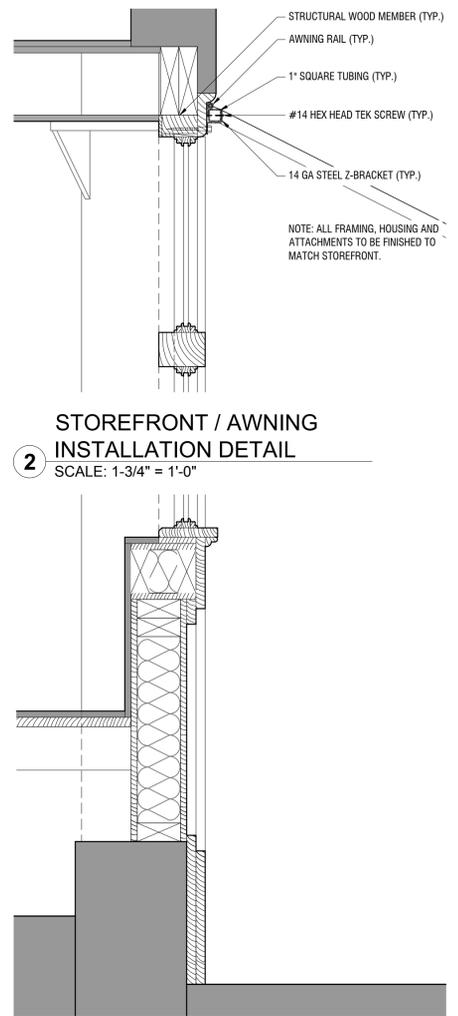

2 STOREFRONT / AWNING INSTALLATION DETAIL
SCALE: 1-3/4" = 1'-0"

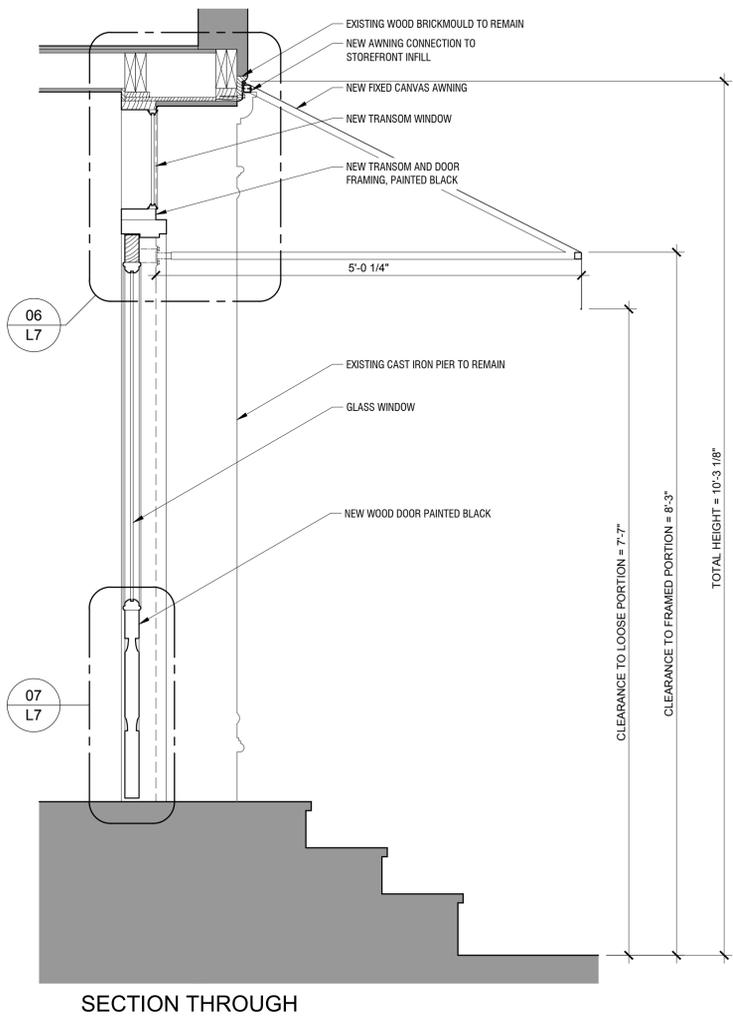


5 SECTION THROUGH ENTRANCE & AWNING (TYP.)
SCALE: 1-3/4" = 1'-0"

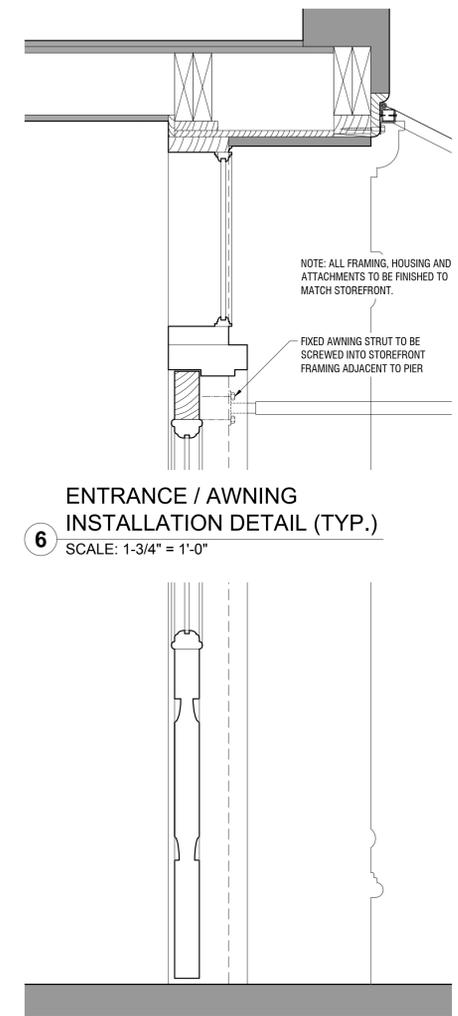


6 ENTRANCE / AWNING INSTALLATION DETAIL (TYP.)
SCALE: 1-3/4" = 1'-0"

7 ENTRANCE DETAIL
SCALE: 1-3/4" = 1'-0"

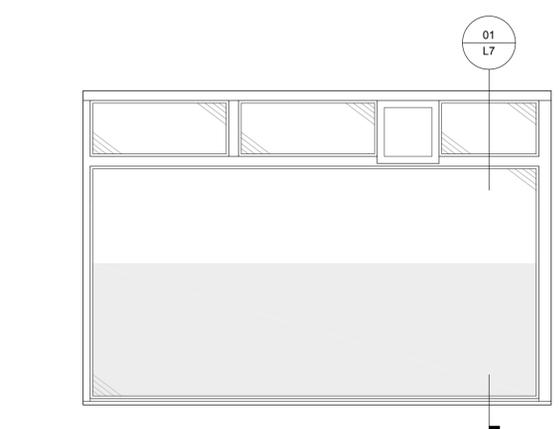

4 STOREFRONT WINDOW
SCALE: 1/2" = 1'-0"

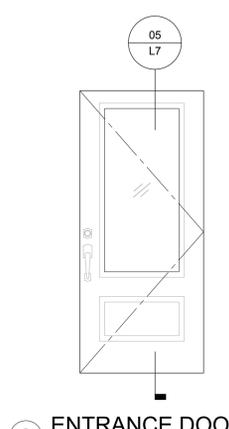

8 ENTRANCE DOOR
SCALE: 1-3/4" = 1'-0"

3 STOREFRONT DETAIL
SCALE: 1-3/4" = 1'-0"

NO	DATE	ISSUE/REVISION	BY
	09/13/2016	LPC SUBMISSION	JC


PROJECT:
19-23 COMMERCE STREET
NEW YORK, NY 10014
STOREFRONTS

TITLE:
**SECTIONS AND DETAILS:
WESTERNMOST
STOREFRONT**


SEAL & SIGNATURE:	DATE:	03/29/2016
	PROJECT NO:	21019
	DRAWING BY:	JC
	CHK BY:	PR
	SCALE:	AS NOTED

DWG NO:
L7
07 of 12


© Copyright 2016 by MK Architecture, P.C. All rights reserved.
It is a violation of the law for any person, unless acting under the direction of a licensed architect, to alter an item in any way. If an item bearing the seal of an architect is altered, the altering architect shall affix to his item the seal and the notation "altered by" followed by his signature and the date of such alteration, and a specific description of the alteration.

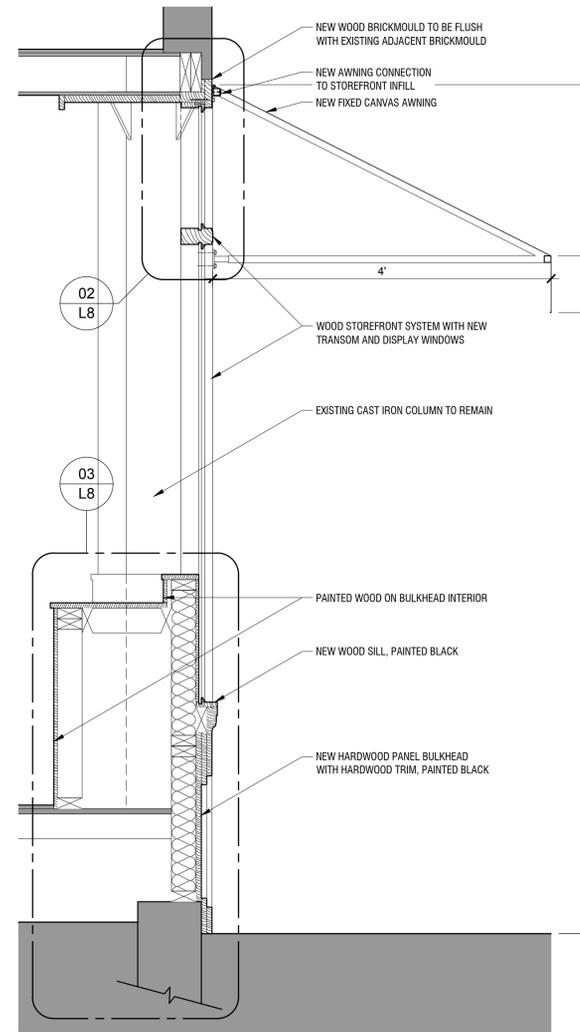


1 SECTION THRU STOREFRONT & AWNING
SCALE: 1" = 1'-0"

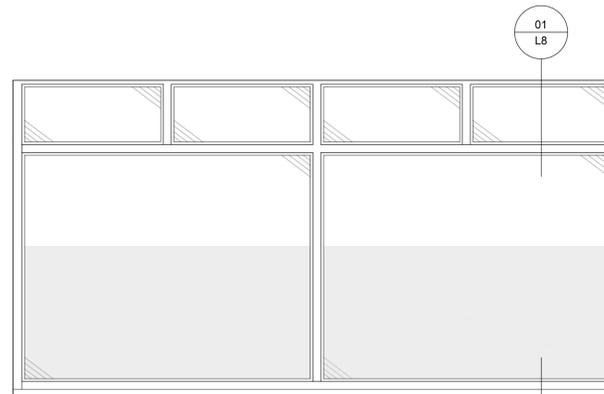

4 STOREFRONT WINDOW
SCALE: 1/2" = 1'-0"

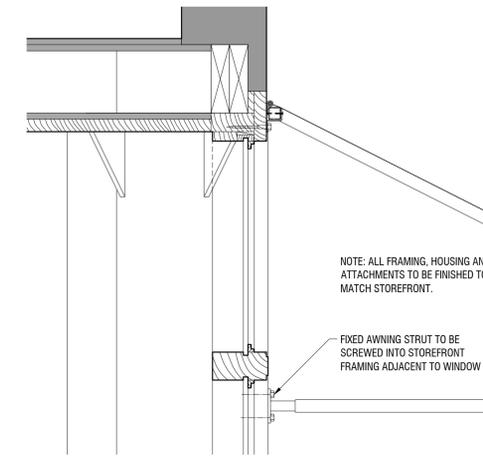

2 STOREFRONT / AWNING INSTALLATION DETAIL
SCALE: 1-3/4" = 1'-0"

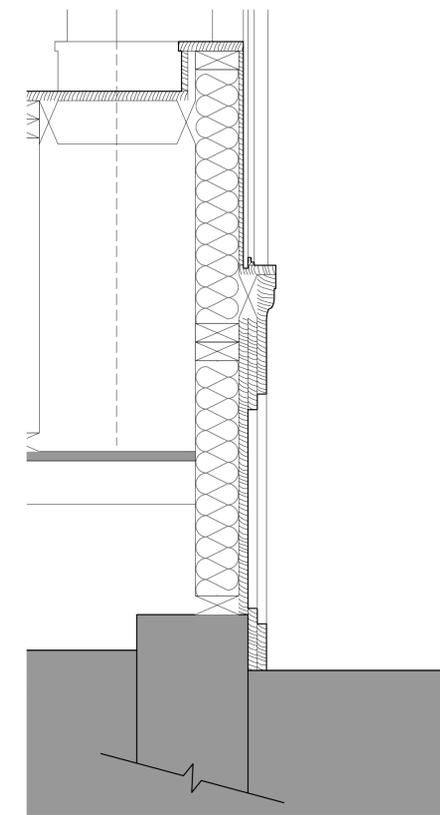

3 STOREFRONT DETAIL
SCALE: 1-3/4" = 1'-0"

Nº	DATE	ISSUE/REVISION	BY
	09/13/2016	LPC SUBMISSION	JC

PROJECT:
19-23 COMMERCE STREET
NEW YORK, NY 10014
STOREFRONTS

TITLE:
SECTIONS AND DETAILS:
2ND WESTERNMOST
STOREFRONT

SEAL & SIGNATURE:	DATE:	03/29/2016
	PROJECT Nº:	21019
	DRAWING BY:	JC
	CHK BY:	PR
	SCALE:	AS NOTED

DWG Nº:
L8



1 LPC DESIGNATION PHOTO



2 DETAIL: WESTERNMOST STOREFRONT BAYS



3 EASTERNMOST STOREFRONT (1932, MUSEUM OF THE CITY OF NEW YORK)



4 PRIOR-TO-CONSTRUCTION: WESTERNMOST STOREFRONTS (©2011 GOOGLE STREET VIEW)



5 PRIOR-TO-CONSTRUCTION: EASTERNMOST STOREFRONTS (©2010 GOOGLE STREET VIEW)

№	DATE	ISSUE/REVISION	BY
	09/13/2016	LPC SUBMISSION	JC

PROJECT:
 19-23 COMMERCE STREET
 NEW YORK, NY 10014
 STOREFRONTS

TITLE:
 PHOTOS:
 HISTORIC AND
 PRIOR-TO-CONSTRUCTION

SEAL & SIGNATURE:	DATE:	03/29/2016
	PROJECT №:	21019
	DRAWING BY:	JC
	CHK BY:	PR
	SCALE:	AS NOTED

DWG №:
L9
 09 of 12



1 GROUND FLOOR ELEVATION: LOOKING EAST



2 GROUND FLOOR ELEVATION: LOOKING WEST



3 23 COMMERCE ST ELEVATION



4 19-23 COMMERCE ST CENTRAL ENTRANCE



5 19 COMMERCE ST ELEVATION



6 23 COMMERCE ST: LOOKING WEST



7 19 COMMERCE ST HISTORIC WINDOWS



8 19 COMMERCE ST STOREFRONT

MKA

MK ARCHITECTURE, PC

217 Broadway, Suite 610
New York, NY 10007
212 352 8866
MKArchitecture.com

№	DATE	ISSUE/REVISION	BY
	09/13/2016	LPC SUBMISSION	JC

PROJECT:
19-23 COMMERCE STREET
NEW YORK, NY 10014
STOREFRONTS

TITLE:
PHOTOS:
AS-BUILT CONDITIONS

SEAL & SIGNATURE:	DATE:	03/29/2016
	PROJECT №:	21019
	DRAWING BY:	JC
	CHK BY:	PR
	SCALE:	AS NOTED

DWG №:
L10

10 of 12
© Copyright 2016 by MK Architecture, P.C. All rights reserved.

It is a violation of the law for any person, unless acting under the direction of a licensed architect, to alter an item in any way. If an item bearing the seal of an architect is altered, the altering architect shall affix to his item the seal and the notation "altered by" followed by his signature and the date of such alteration, and a specific description of the alteration.



1 LPC DESIGNATION PHOTO: MASONRY BAND DETAILS



2 CURRENT CONDITION: MASONRY BAND DETAILS



3 HISTORIC WINDOW DETAIL



4 STOREFRONT ELEVATION: LOOKING WEST



5 AS-BUILT CONDITION: STOREFRONT BRACKET SIGN AND LIGHT FIXTURE

Nº	DATE	ISSUE/REVISION	BY
	09/13/2016	LPC SUBMISSION	JC

PROJECT:
 19-23 COMMERCE STREET
 NEW YORK, NY 10014
 STOREFRONTS

TITLE:
 PHOTOS:
 19 COMMERCE STREET
 FACADE DETAILS

SEAL & SIGNATURE:	DATE:	03/29/2016
	PROJECT Nº:	21019
	DRAWING BY:	JC
	CHK BY:	PR
	SCALE:	AS NOTED

DWG Nº:
L11



1 AS-BUILT CONDITION: AWNING FACADE CONNECTIONS



2 PRIOR-TO-CONSTRUCTION: WESTERNMOST STOREFRONT (© 2011 GOOGLE STREET VIEW)



3 PRIOR-TO-CONSTRUCTION: ENTRANCE (© 2012 GOOGLE STREET VIEW)



4 PRIOR-TO-CONSTRUCTION: 2nd WESTERNMOST STOREFRONT (© 2011 GOOGLE STREET VIEW)



5 AS-BUILT CONDITION: WESTERNMOST STOREFRONT



6 AS-BUILT CONDITION: 23 COMMERCE ST ENTRANCE



7 AS-BUILT CONDITION : 2nd WESTERNMOST STOREFRONT

№	DATE	ISSUE/REVISION	BY
	09/13/2016	LPC SUBMISSION	JC

PROJECT:
 19-23 COMMERCE STREET
 NEW YORK, NY 10014
 STOREFRONTS

TITLE:
 PHOTOS:
 23 COMMERCE STREET
 FACADE DETAILS

SEAL & SIGNATURE:	DATE:	03/29/2016
	PROJECT №:	21019
	DRAWING BY:	JC
	CHK BY:	PR
	SCALE:	AS NOTED

DWG №:
L12
 12 of 12

© Copyright 2016 by MK Architecture, P.C. All rights reserved.

It is a violation of the law for any person, unless acting under the direction of a licensed architect, to alter an item in any way. If an item bearing the seal of an architect is altered, the altering architect shall affix to his item the seal and the notation "altered by" followed by his signature and the date of such alteration, and a specific description of the alteration.